
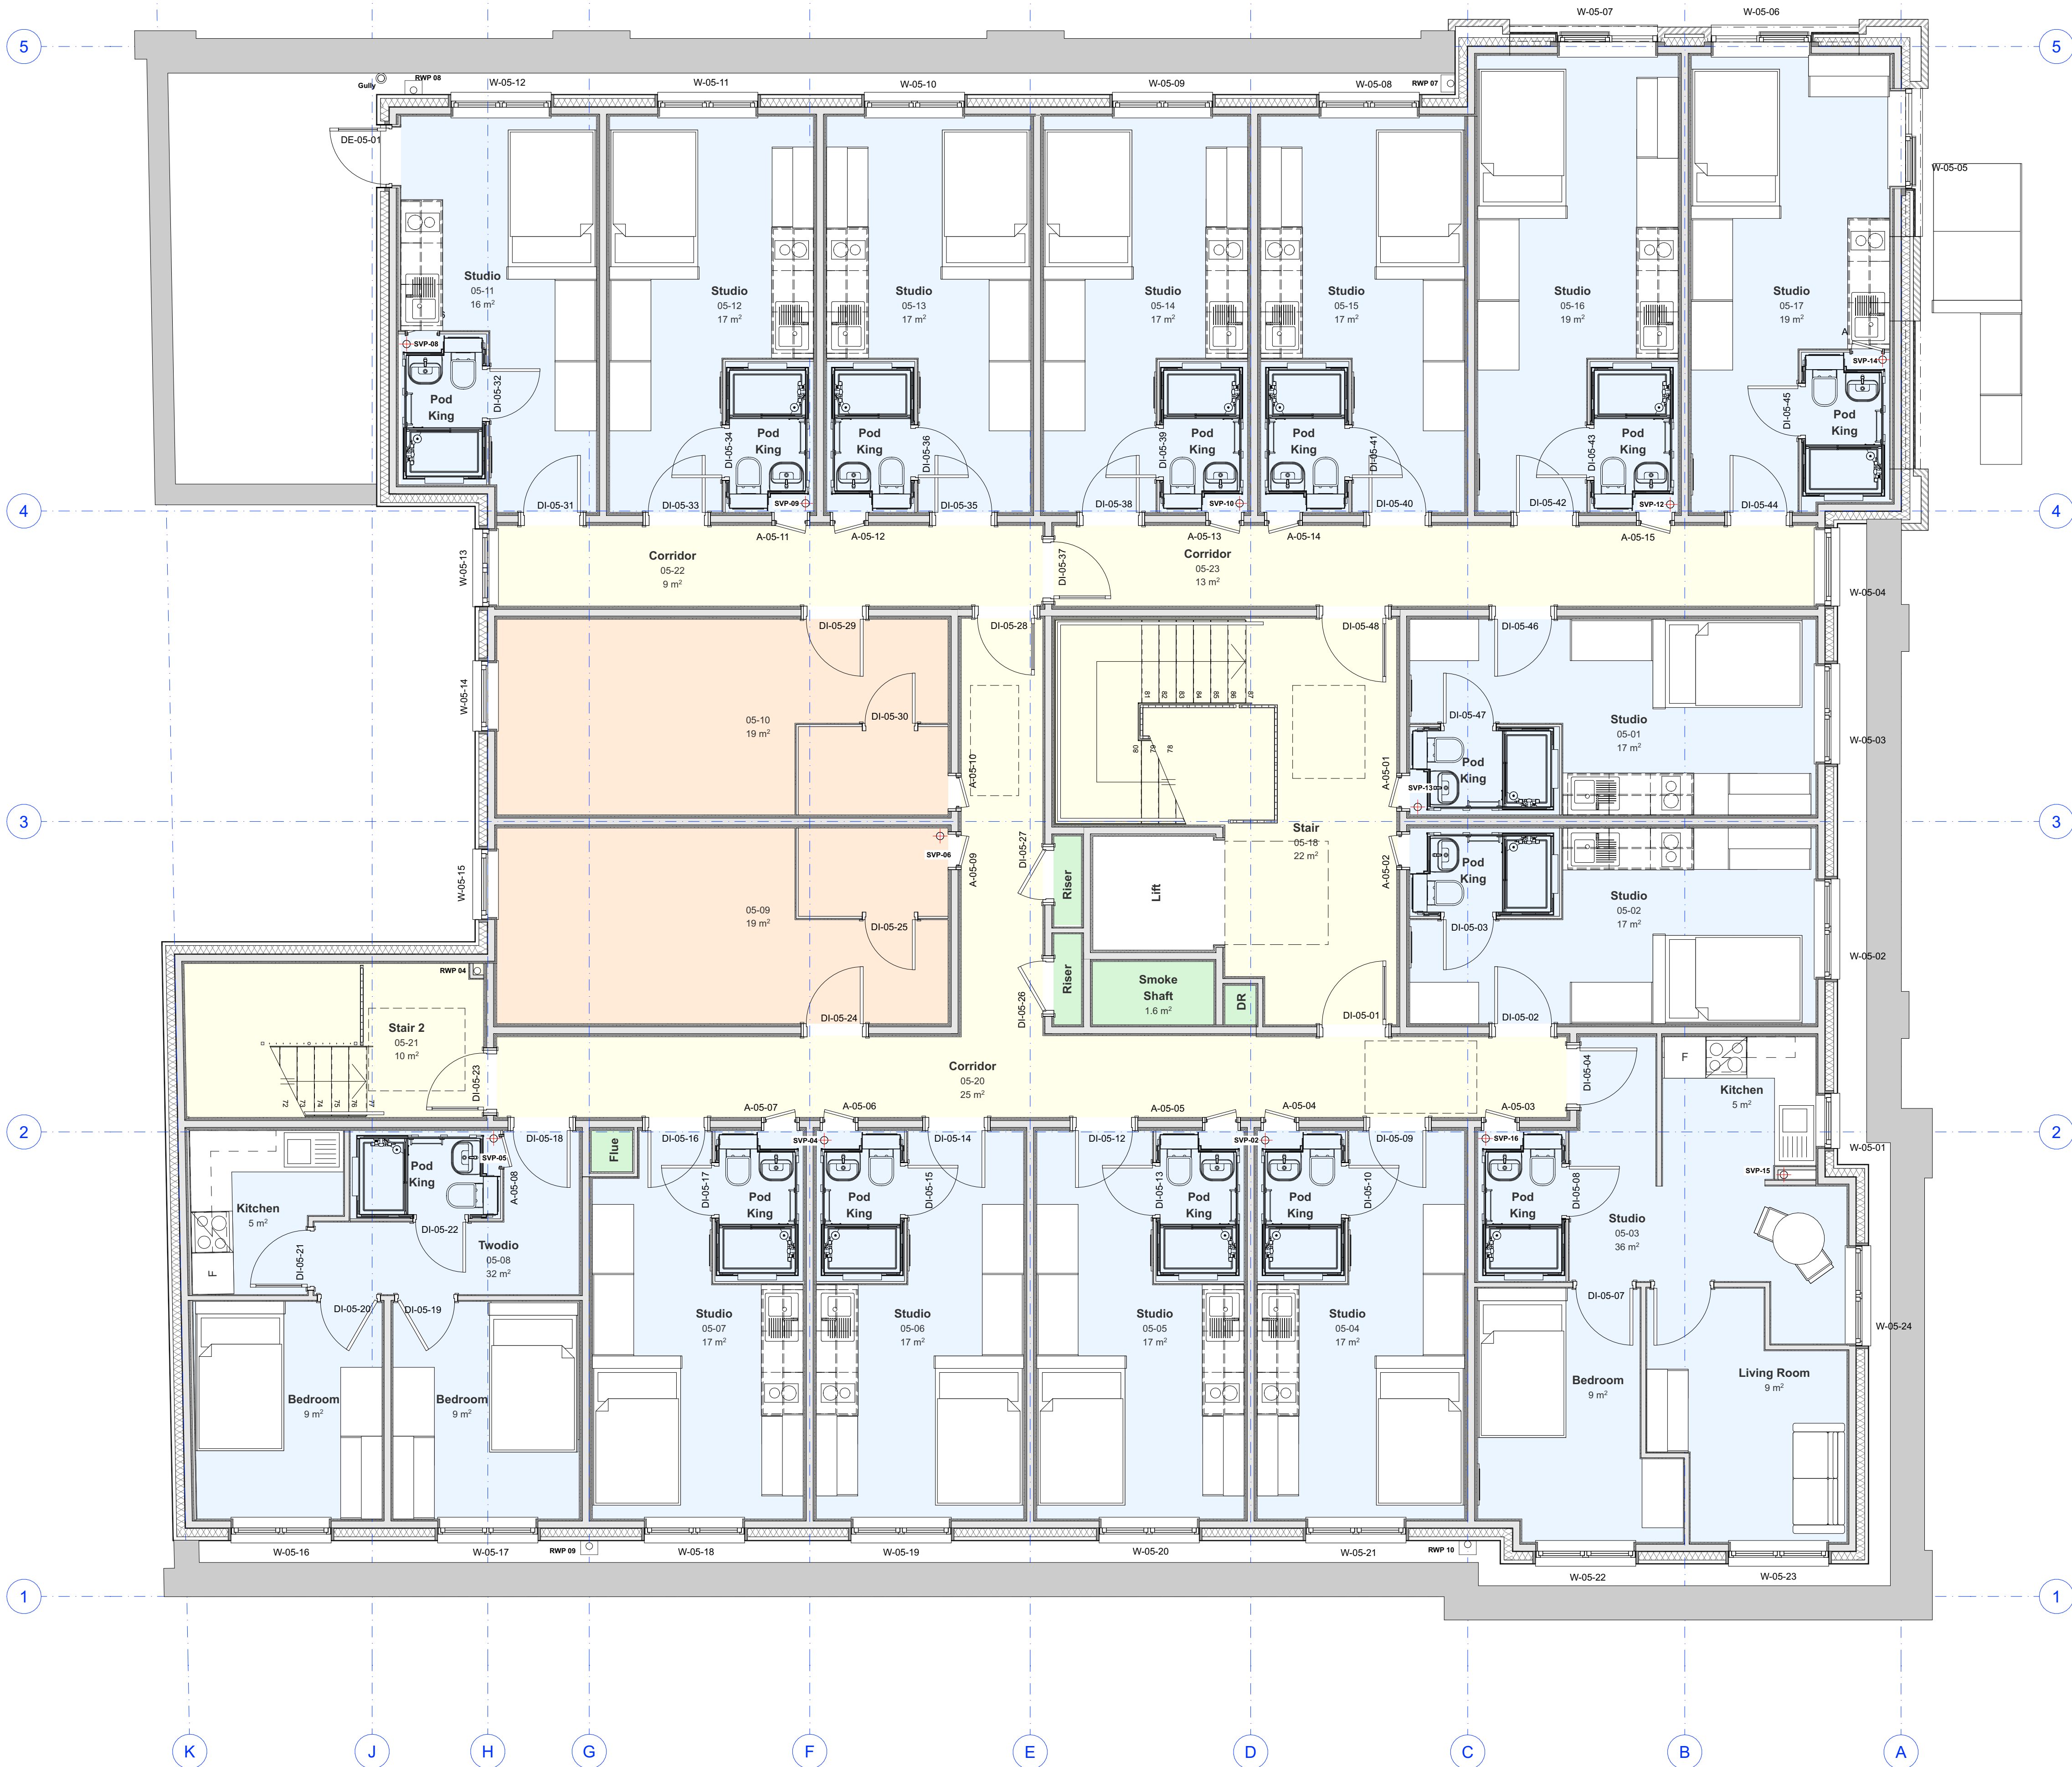


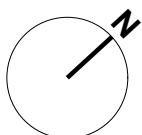

- 21 29.06.2026 PT As Built
20 20.01.2026 PT Layout of Studio 05-03 amended
19 27.11.2025 PT External door added to Studio 05-11
18 06.11.2025 PT Furniture layouts amended
17 29.09.2025 PT Mid corridor door and damper to smoke shaft omitted
16 06.06.2025 PT Mid height partition added to bedrooms and furniture layout amended
15 03.04.2025 PT Window W-05-13 amended
14 10.03.2025 PT Window W-05-04 amended
13 06.03.2025 PT Door DI-05-48 added to smoke shaft
12 27.02.2025 PT Ensuites in Studios 05-11 and 17 amended and SVP's 08 and 14 moved
11 10.01.2025 PT Access panels added.
10 04.12.2024 PT RWP's amended.
09 02.12.2024 PT Ensuite pods and SVP's amended.
08 13.09.2024 PT External wall thickness to Wade and Great George Street elevations amended.
07 23.07.2024 PT Minor amendments to liftshaft size.
06 15.07.2024 PT View rotated. Gridline K added. External wall along Gridline K moved. Internal walls within Twodios 05-03 and 05-08 amended.
05 01.07.2024 PT External wall thickness amended. SFS wall to side of Stair 2 moved.
04 06.06.2024 PT External wall to Units 05-16 and 05-17 moved. Studio 05-17 added. External wall thickness amended. Shower pods amended. RWP positions amended.
03 17.05.2024 PT External wall adjacent to Redwood House amended. Partitions between studios 05-11 to 15 adjusted.
02 01.05.2024 PT Windows amended. Stair amended. Window numbers and RWP's added. Kitchen in 05-16 amended.

Rev Date By Description

noma architects

14 Guinea Street
Redcliffe, Bristol BS1 6SX
T 0117 929 2041
E mail@noma-uk.com
www.noma-uk.com

Job
11-17 Wade Street, Bristol

Client
Wade Street Ltd

Drawing Title
Fifth Floor - General Arrangement

Drawing Number
2502 4106 21

Project Number Revision

As Built **1:50**

Purpose of Issue Scale

PT 15.04.2024 A1

Drawn Checked Issue Date Size

2502 **Noma** - - DR A S1

NOMA Project No Owner Zone Level Type Role Status